

Beazer East, Inc.

Former Koppers Wood-Treating Site – Carbondale, Illinois

Soil Removal and Surface Cover Remediation Project

Weekly Report #7: 11/23/20 – 11/29/20



**Soil Removal and Surface Cover
Former Koppers Wood-Treating Site
Carbondale, IL**

WEEKLY PROGRESS REPORT

Reporting Period: Monday, November 23rd, 2020 to Sunday, November 29th, 2020

Progress Meeting Date: No meeting this week

1.0 Weather Conditions

Date		Conditions	Wind	Precipitation (in)
Monday	11/23/20	Clear, 34-66 °F	8/WSW	0
Tuesday	11/24/20	Clear, 30-53 °F	6.5/ENE	0
Wednesday	11/25/20	Not On-Site		1.24
Thursday	11/26/20	Not On-Site		0
Friday	11/27/20	Not On-Site		0
Saturday	11/28/20	Not On-Site		0
Sunday	11/29/20	Not On-Site		0
Week Total				1.24
Site Cumulative				9.65

2.0 Health & Safety

Manhours Completed this Period: 140

Manhours Completed to Date: 3280

Notes

Day	Tailgate Topic(s)
Monday	Slip hazards with focus on ice
Tuesday	Staying focused on task at hand, COVID precautions during Thanksgiving holiday
Wednesday	-
Thursday	-
Friday	-
Saturday	-
Sunday	-

3.0 ENTACT Work Activities Summary

Monday – November 23, 2020
Continued geotextile and general fill placement in Soil Removal Area 1.
Tuesday – November 24, 2020
Continued geotextile and general fill placement in Soil Removal Area 1.
Wednesday – November 25, 2020
Not On-Site
Thursday – November 26, 2020
Not On-Site
Friday – November 27, 2020
Not On-Site
Saturday – November 28, 2020
Not On-Site
Sunday – November 29, 2020
Not On-Site

4.0 ENTACT Subcontractors

Date	Subcontractor/Vendor/ Third Party	Work Activity
11/24/2020	Fabick CAT	Performed repair on ENTACT equipment

5.0 ENTACT Deliveries

Material Import – Current Week		
Date	Description	Quantity
11/23/2020	General Fill	1220 tons
11/23/2020	RipRap-1	41.03 tons
11/24/2020	General Fill	1109.75 tons

Material Import – To Date	
Description	Quantity
General Fill	10945.62 tons
CA-2	1886.65 tons
Demarcation Fabric	405000 SF
Filter Sock	10230 LF
RipRap-1	133.37 tons

6.0 Material Export

Material Export – Current Week		
Date	Description	Quantity

None

Material Export – To Date	
Description	Quantity
Impacted Soils	17721.50 tons

7.0 Construction Quality Control

See Attached Reports and Logs:

- Progress Photos
- Progress Map
- Current Project Schedule


8.0 Request for Information (RFIs)

- RFI 001 – Stabilized Construction Entrance Aggregate (Approved)
- None pending

9.0 Change in Conditions

- None

Picture Number	1	
Date	11/24	
Direction	NE	
Description: Grading general fill placed over Soil Removal Area 1. As seen from N Marion St northbound.		
Picture Number	2	
Date	11/24	
Direction	E	
Description: Truck delivering imported general fill to Soil Removal Area 1.		

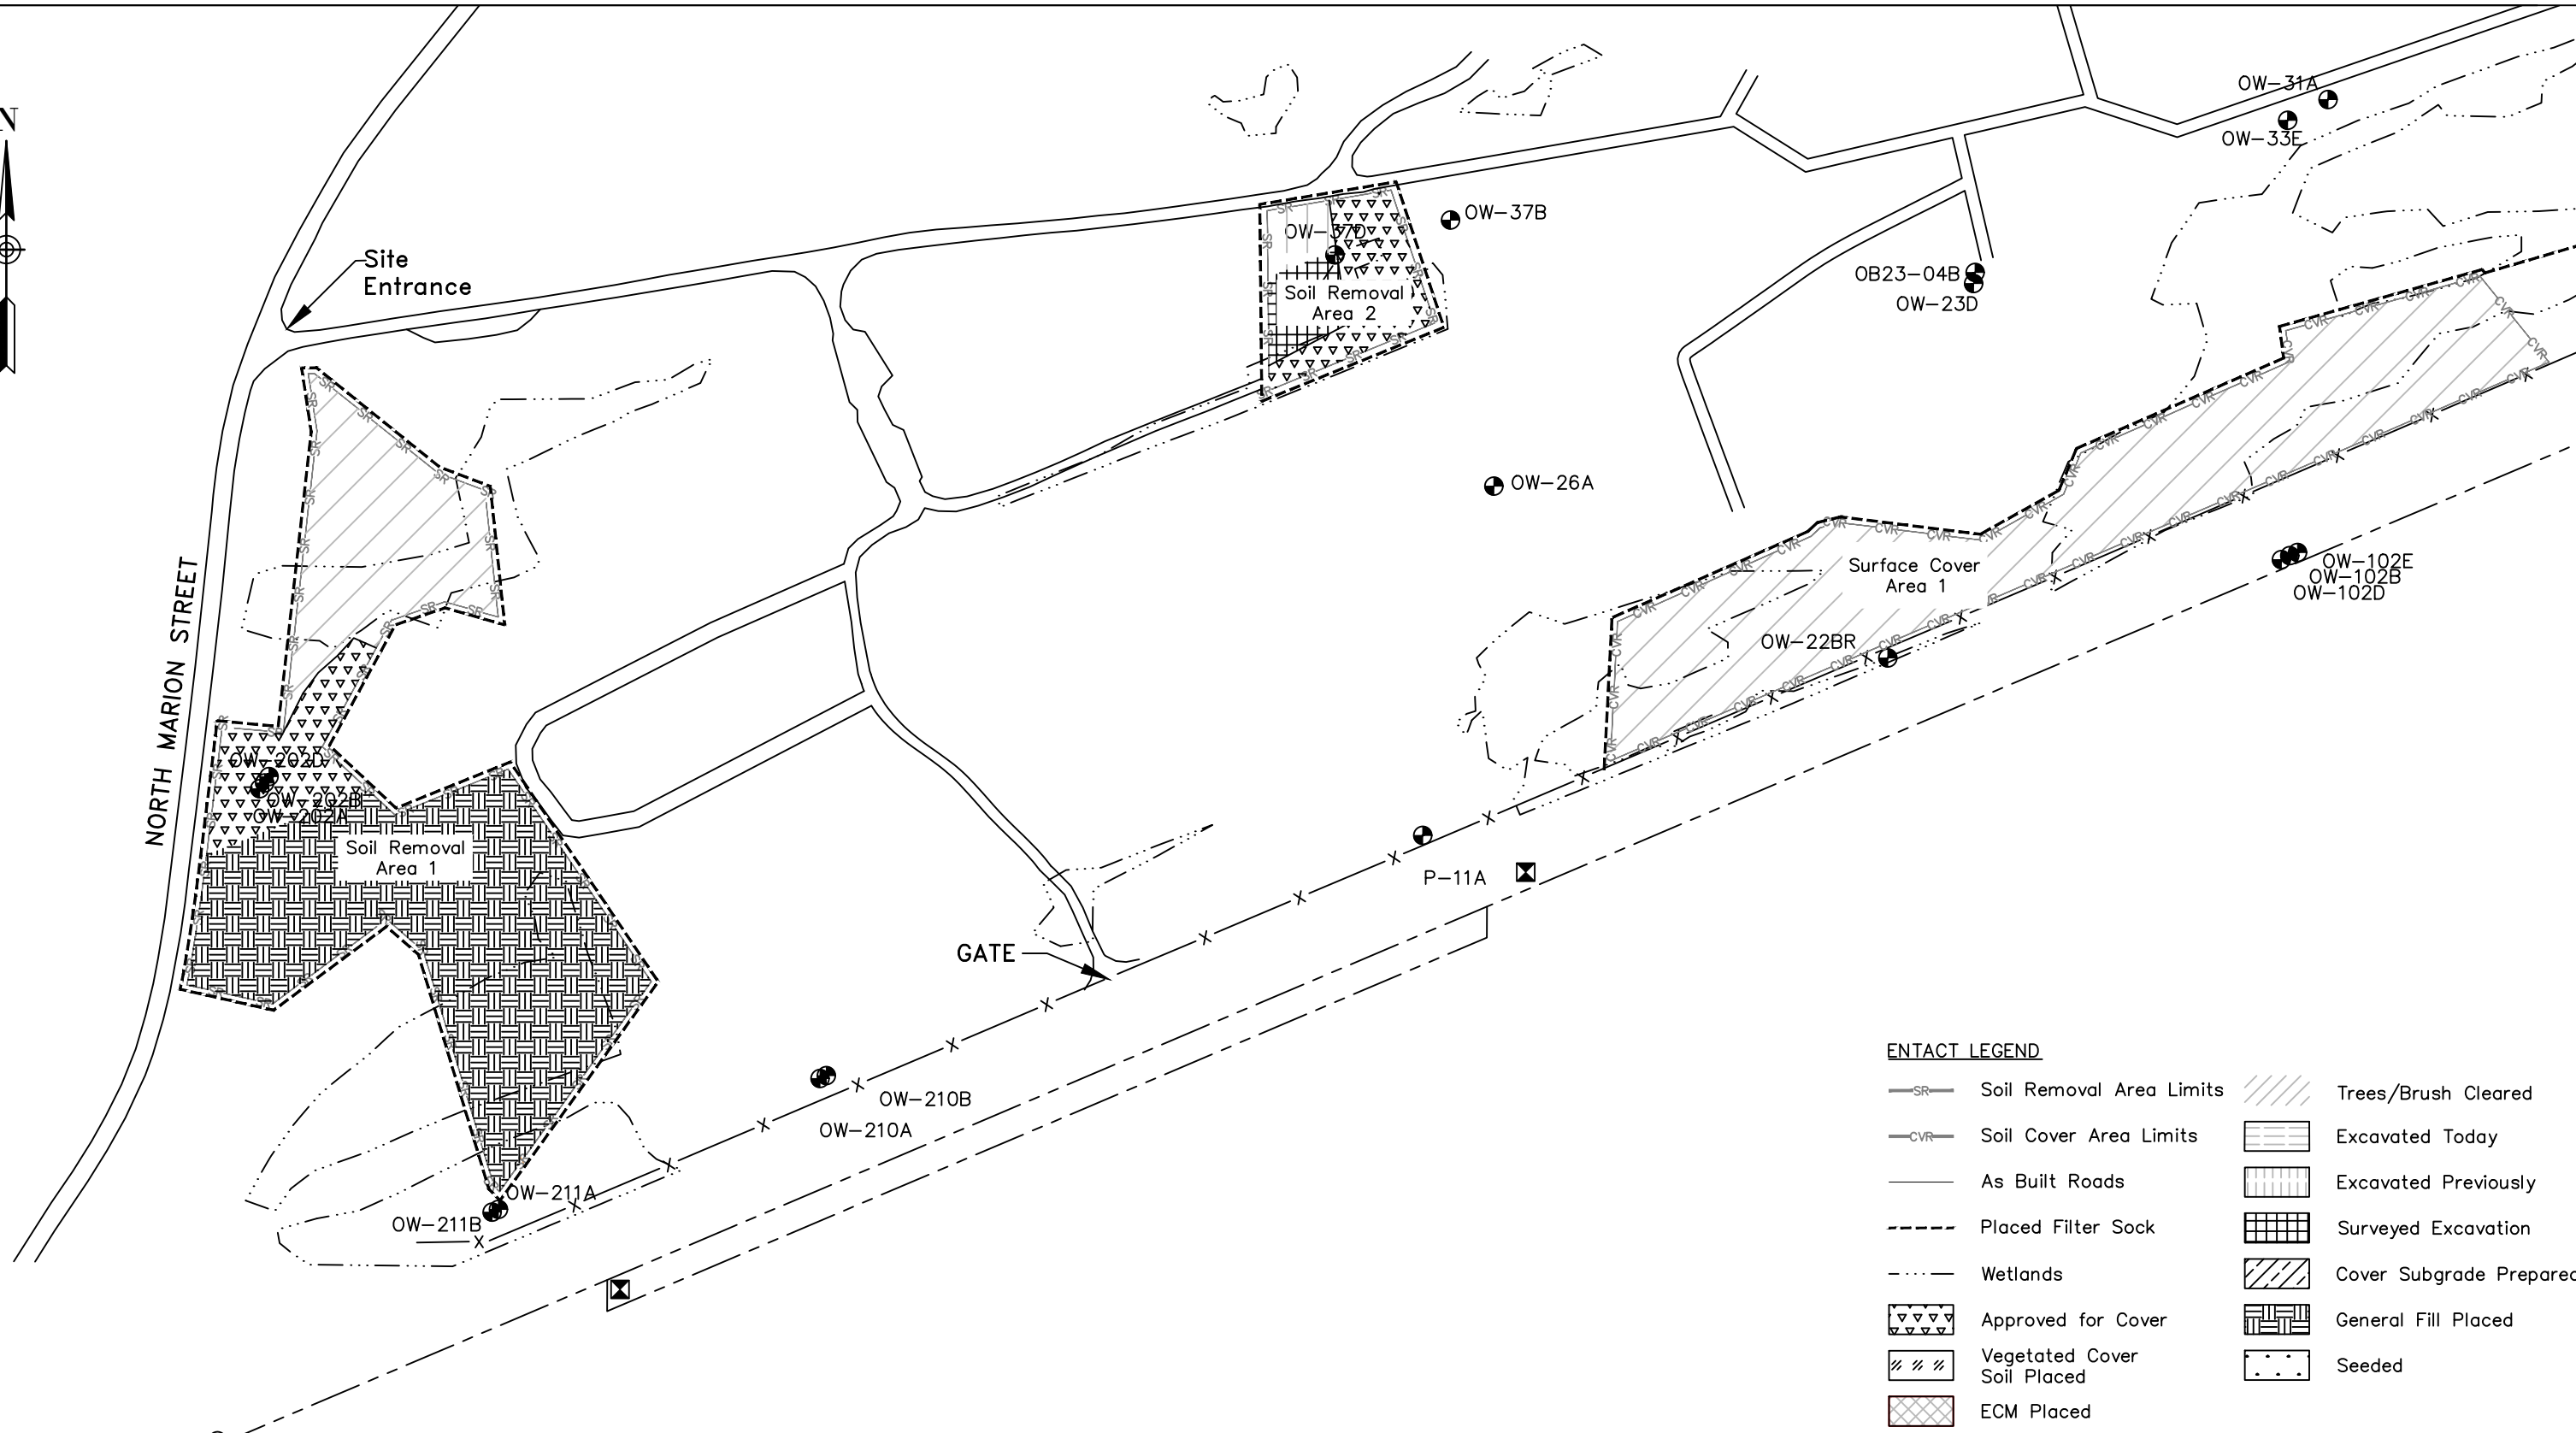

ENTACT LEGEND

Soil Removal Area Limits	Trees/Brush Cleared
Soil Cover Area Limits	Excavated Today
As Built Roads	Excavated Previously
Placed Filter Sock	Surveyed Excavation
Wetlands	Cover Subgrade Prepared
Approved for Cover	General Fill Placed
Vegetated Cover Soil Placed	Seeded
ECM Placed	

REV	DATE	BY	CHK'D	APR'VD	DESCRIPTION

PREPARED FOR:
BEAZER EAST
PITTSBURGH, PA


SCALE: 1"=200'

ENTACT

DRAWING NAME: **Daily Progress Figure – Site West**

PROJECT NAME & LOCATION: **SOIL REMOVAL AND SURFACE COVER REMEDY
FORMER KOPPERS WOOD-TREATING SITE
CARBONDALE, IL**

DRAWN BY	K. KLIPPSTEIN	APPROVED BY	T. MORAN	REV	0	SHEET NO.
DATE	11/24/2020	DATE		PROJECT NO.	E8658	1 OF 2

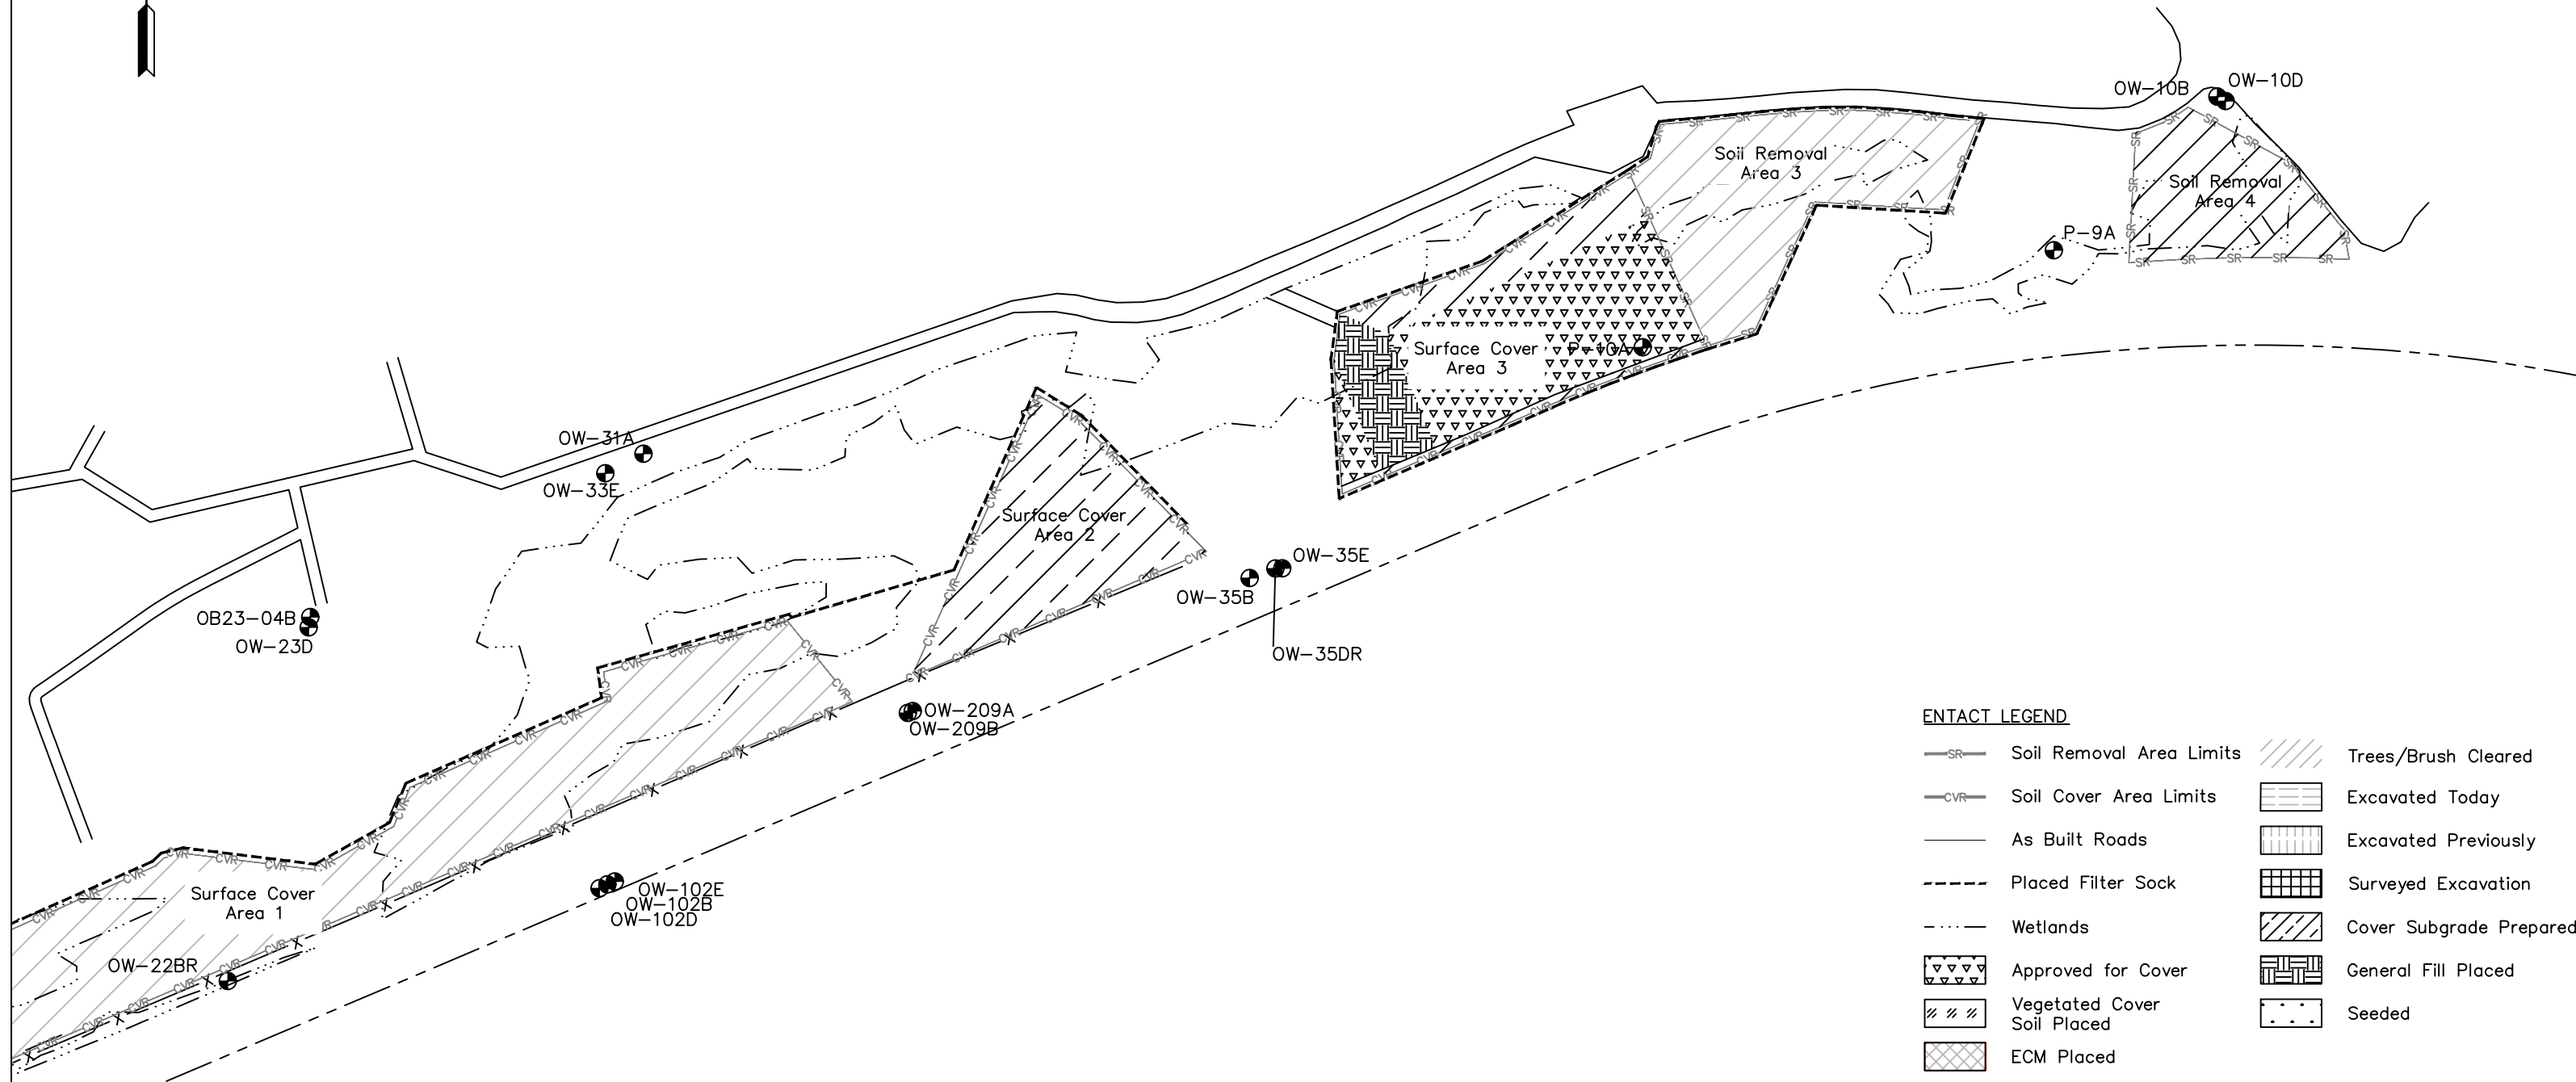


ENTACT LEGEND

- SR— Soil Removal Area Limits
- CVR— Soil Cover Area Limits
- As Built Roads
- - - - Placed Filter Sock
- · · · Wetlands
- ▽▽▽▽ Approved for Cover
- /// Vegetated Cover Soil Placed
- ECM Placed
- /// Trees/Brush Cleared
- Excavated Today
- Excavated Previously
- Surveyed Excavation
- Cover Subgrade Prepared
- General Fill Placed
- Seeded

REV	DATE	BY	CHK'D	APR'VD	DESCRIPTION

PREPARED FOR:
BEAZER EAST
PITTSBURGH, PA

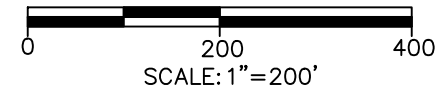

ENTACT

DRAWING NAME: Daily Progress Figure – Site East

PROJECT NAME & LOCATION: SOIL REMOVAL AND SURFACE COVER REMEDY
FORMER KOPPERS WOOD-TREATING SITE
CARBONDALE, IL

DRAWN BY	K. KLIPPSTEIN	APPROVED BY	T. MORAN	REV	0	SHEET NO.
DATE	11/24/2020	DATE		PROJECT NO.	E8658	2 OF 2

Beazer East, Inc.
Soil Removal and Surface Cover Remedial Design
Former Koppers Wood-Treating Site
Carbondale, Illinois

