




REVISIONS				
NO.	DESCRIPTION	PREP'D BY	DATE	APPROVED
1	REVISED TO SHOW AS-BUILT CONDITIONS	EST. 10/11/50		

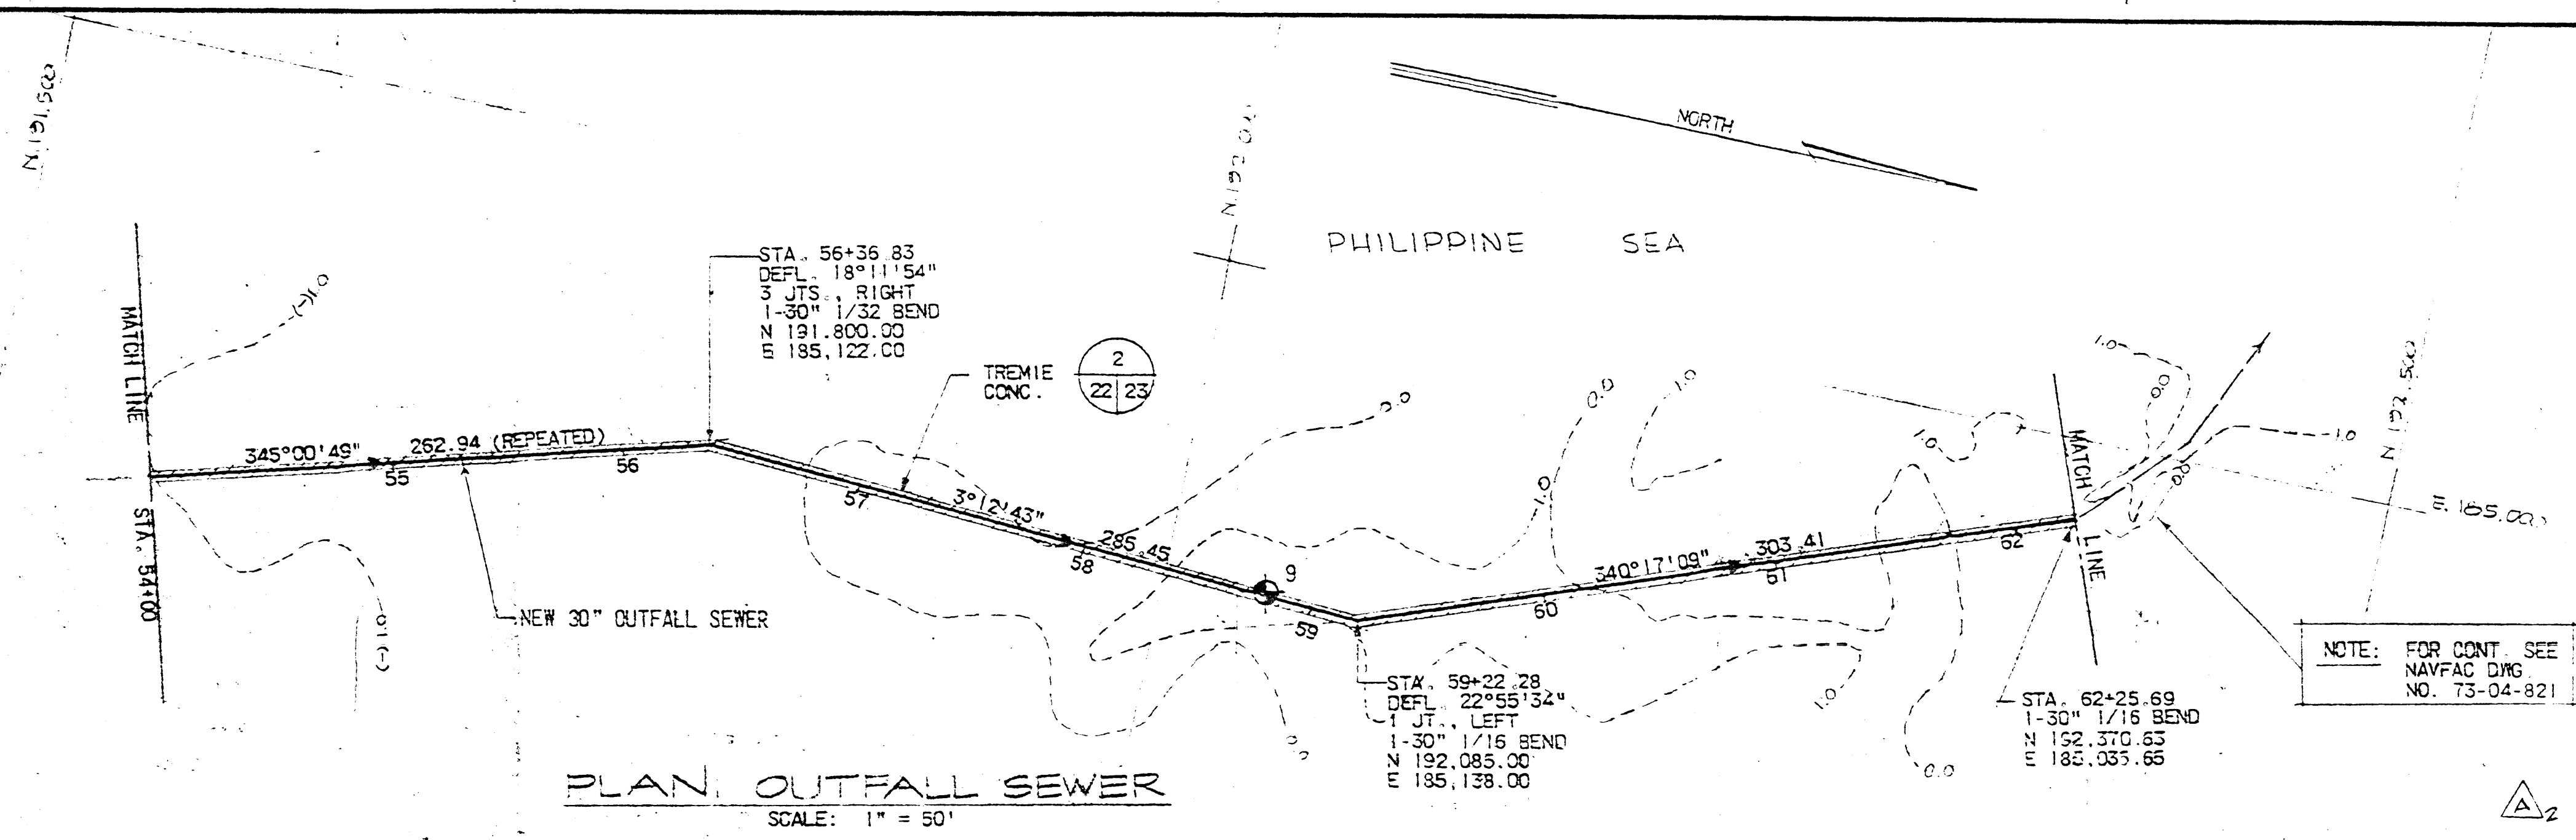

NOTE: FOR CONT. SEE
NAVJAG DIB
NO. 73-04-821

NOTE:
ASBESTOS CEMENT PIPE STRENGTH CLASS
SHALL BE DETERMINED IN ACCORDANCE
WITH SPECIFICATION SECTION 4-13

RM (TECHNICAL PIPE)
SEE APPROVED SPECIFICATION

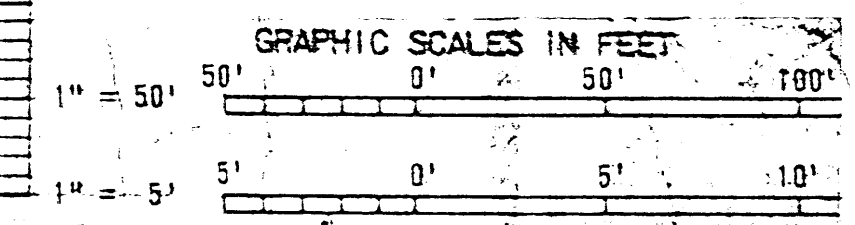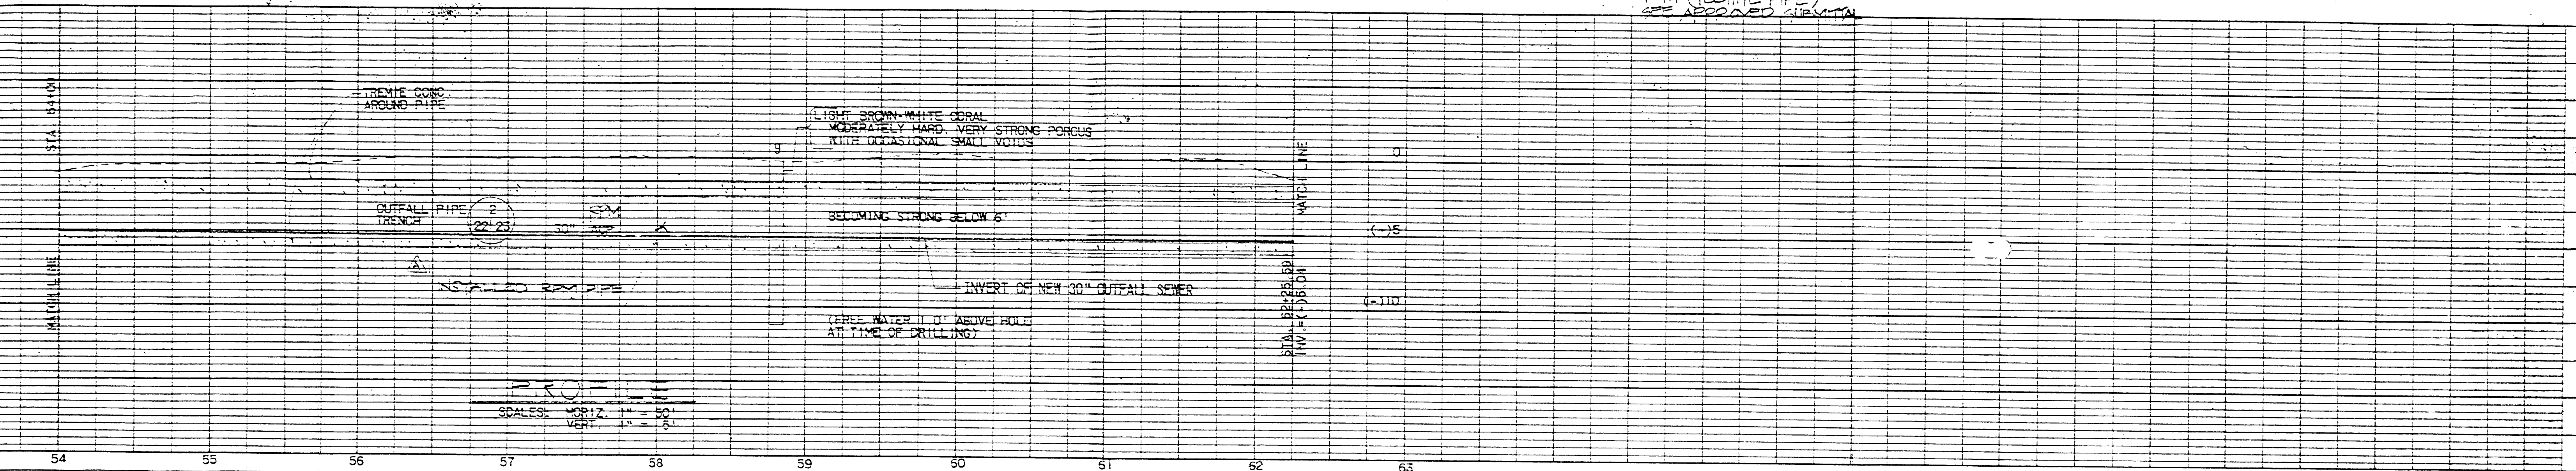

ASA AUSTIN, SMITH & ASSOC., INC. ENGINEERS - ARCHITECTS - SURVEYORS 1001 K STREET, N.W. WASHINGTON, D.C. 20004		DEPARTMENT OF THE NAVY - NAVAL FACILITIES ENGINEERING COMMAND OFFICER IN CHARGE OF CONSTRUCTION NAVAL FACILITIES ENGINEERING COMMAND CONTRACTS - HAWAIIAN GUAM, M.I.	
DRAWN BY: <i>[Signature]</i> CHECKED BY: <i>[Signature]</i> DATE: 7/27/75		NORTHERN DISTRICT SEWERAGE SYSTEM NORTHERN LINK AND TREATMENT PLANT SUMMIT HILL, GUAM PLAN & PROFILE OUTFALL SEWER STA. 54+00 TO STA. 62+25.69	
APPROVED BY: <i>[Signature]</i> DATE: 7/27/75		NAVJAG DRAWING NO. F 80091 CONTRACT NO. 73-04-821	
OFFICER IN CHARGE COMMANDER, NAVAL FACILITIES ENGINEERING COMMAND GUAM, M.I.		SPEC. 41-74-0240 SHEET 22 OF 22	