



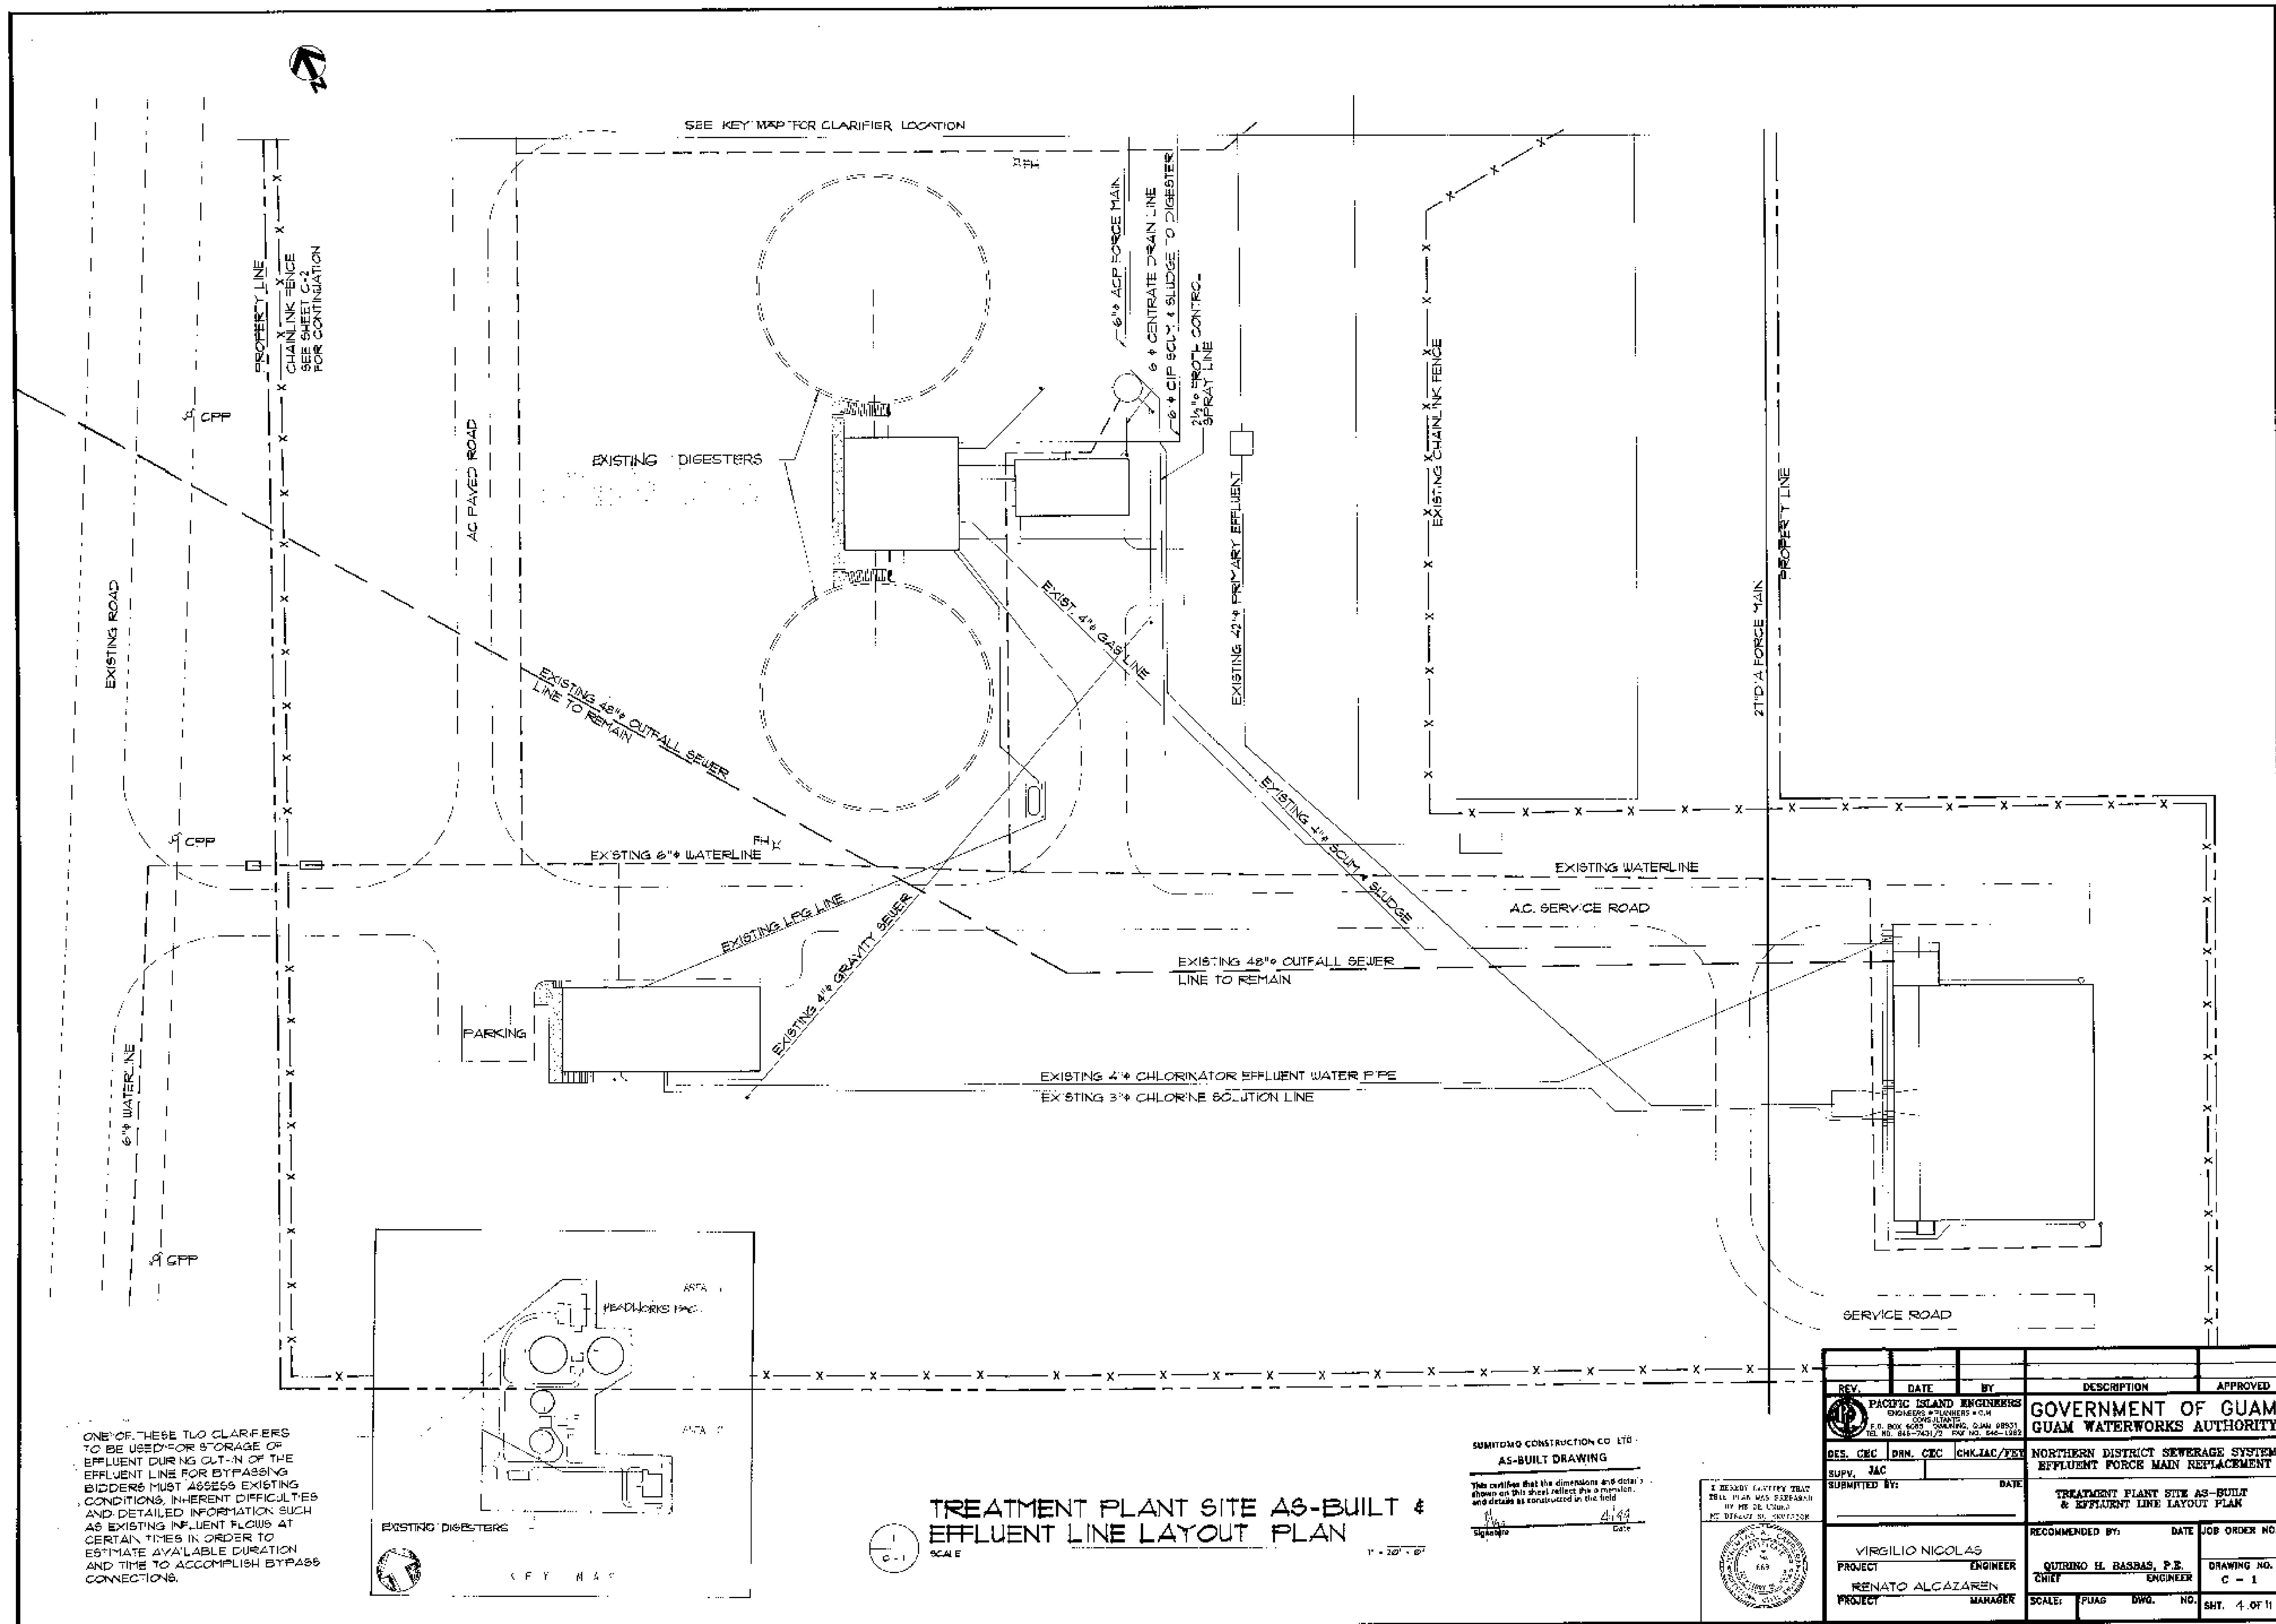

ONE OF THESE TWO CLARIFIERS TO BE USED FOR STORAGE OF EFFLUENT DURING CUT-IN OF THE EFFLUENT LINE FOR BYPASSING. BIDDERS MUST ASSESS EXISTING CONDITIONS, INHERENT DIFFICULTIES AND DETAILED INFORMATION SUCH AS EXISTING INFLUENT FLOWS AT CERTAIN TIMES IN ORDER TO ESTIMATE AVAILABLE DURATION AND TIME TO ACCOMPLISH BYPASS CONNECTIONS.

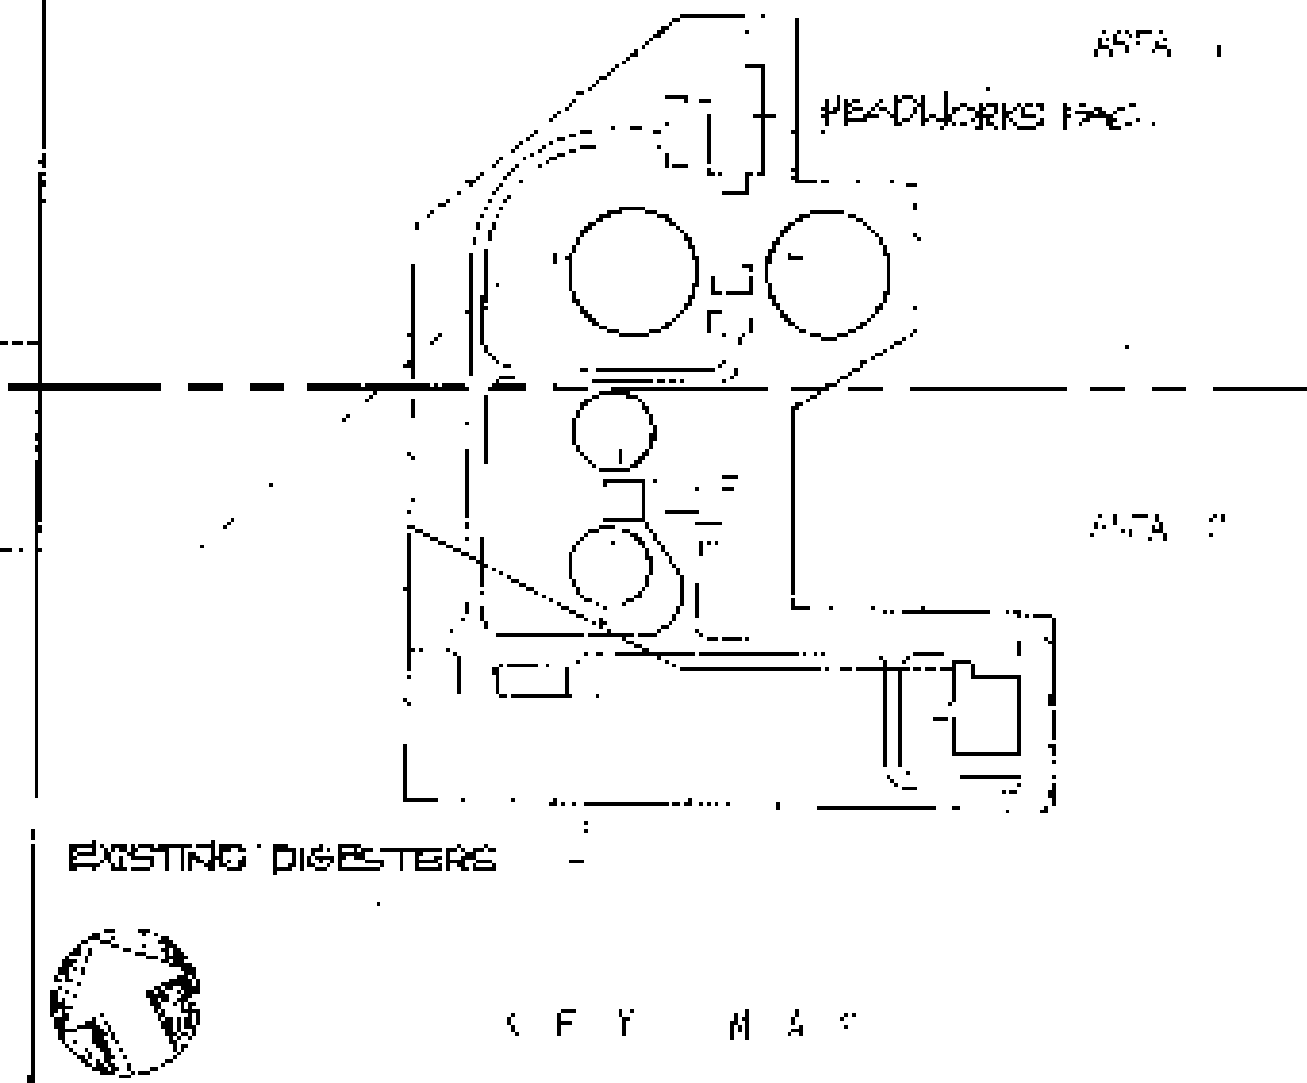


TREATMENT PLANT SITE AS-BUILT & EFFLUENT LINE LAYOUT PLAN

SCALE 1" = 20' - 0"

SUBMITTING CONSTRUCTION CO. LTD.
AS-BUILT DRAWING

This certifies that the dimensions and details shown on this sheet reflect the as-constructed and details as constructed in the field.

Signature: *[Signature]* Date: 4/89

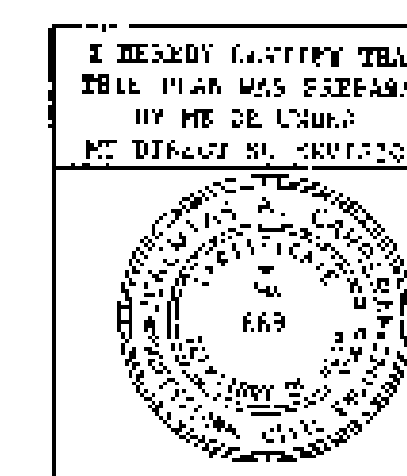

REV.	DATE	BY	DESCRIPTION	APPROVED
DES. CEC	DN. CEC	CHK. IAC/TEV	SUPV. JAC	
PACIFIC ISLAND ENGINEERS ENGINEERS & PLANNERS P.C.A. 1000 SHAW BLVD. SUITE 200, GUAM 98001 TEL. NO. 844-7431/23 FAX NO. 844-1382				
GOVERNMENT OF GUAM GUAM WATERWORKS AUTHORITY NORTHERN DISTRICT SEWERAGE SYSTEM EFFLUENT FORCE MAIN REPLACEMENT				
SUBMITTED BY:			DATE:	
VIRGILIO NICOLAS			ENGINEER	
REYNATO ALCAZAREN			MANAGER	
RECOMMENDED BY:			DATE:	
QUIRINO H. BASBAS, P.E.			ENGINEER	
JOB ORDER NO.			DRAWING NO.	
C - 1			SHT. 4 OF 11	