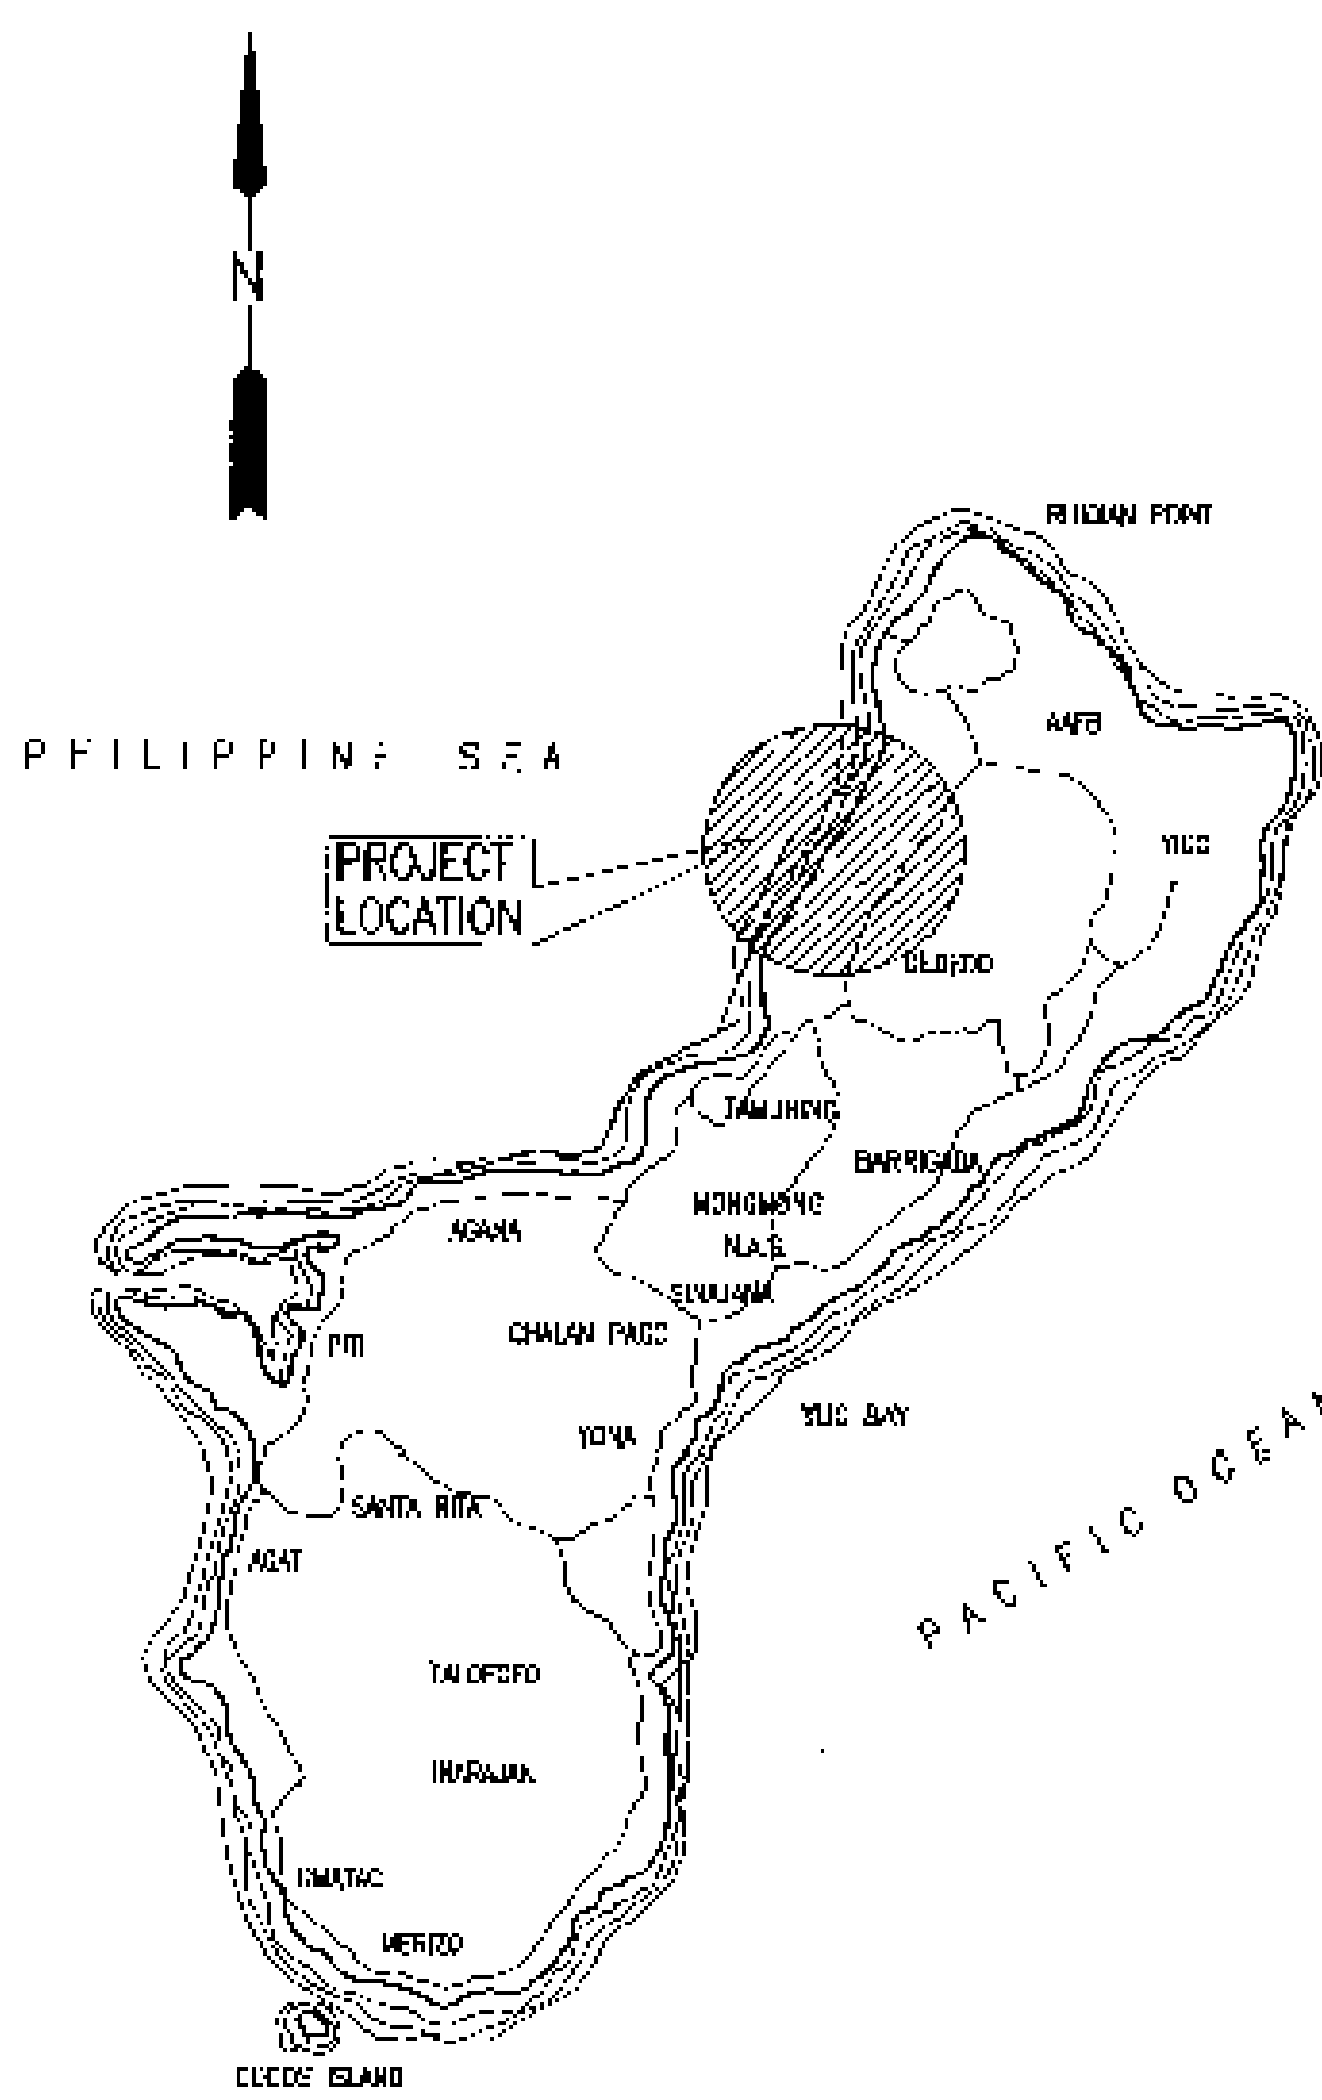
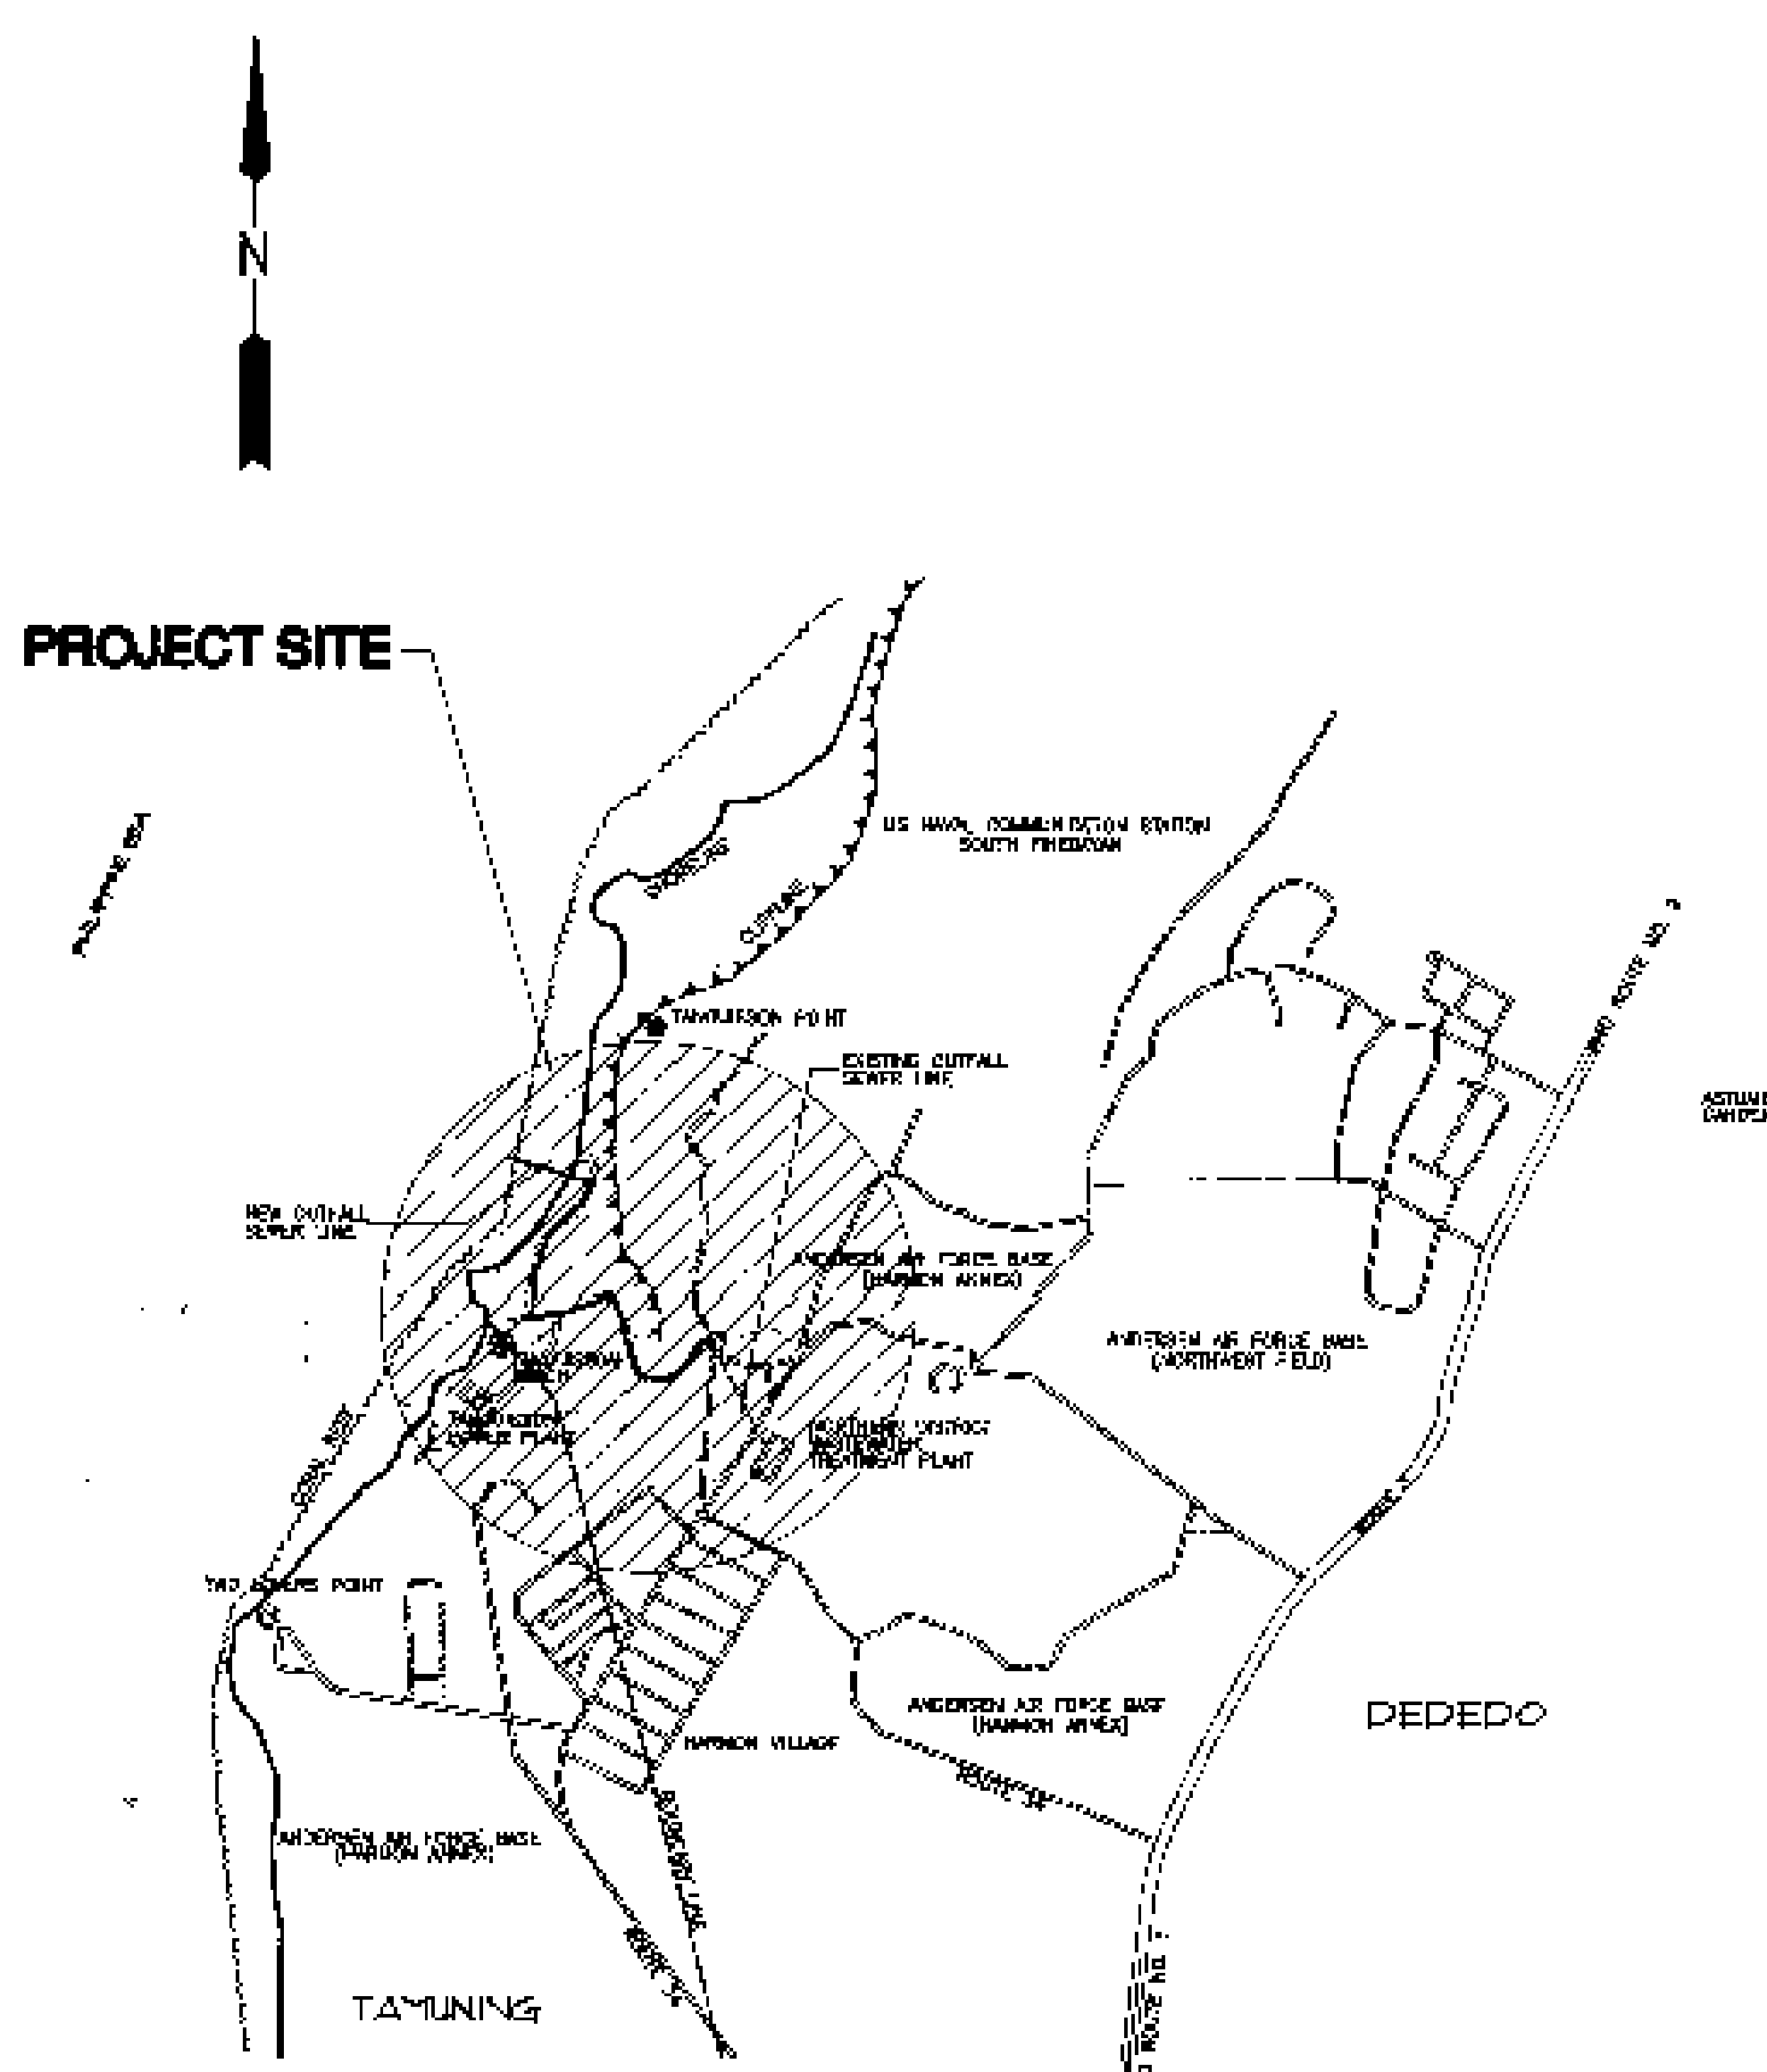


NORTHERN DISTRICT SEWERAGE SYSTEM EFFLUENT FORCE MAIN REPLACEMENT

PROJECT NO. S97 - 001 - LOC

GUAM WATERWORKS AUTHORITY
GOVERNMENT OF GUAM

LOCATION MAP	VICINITY MAP	INDEX OF DRAWINGS	APPROVALS																																														
		<table border="1"><thead><tr><th>DRAWING NO.</th><th>DESCRIPTION</th><th>SHEET NO.</th></tr></thead><tbody><tr><td>TS - 1</td><td>TITLE SHEET, LOCATION MAP, VICINITY MAP AND INDEX OF DRAWINGS</td><td>1 OF 11</td></tr><tr><td>LS - 1</td><td>GENERAL NOTES, ABBREVIATIONS & SYMBOLS</td><td>2 OF 11</td></tr><tr><td>MP - 1</td><td>KEY MAP</td><td>3 OF 11</td></tr><tr><td>C - 1</td><td>TREATMENT PLANT SITE AS-BUILT & EFFLUENT LINE LAYOUT PLAN</td><td>4 OF 11</td></tr><tr><td>C - 2</td><td>PLAN AND PROFILE</td><td>5 OF 11</td></tr><tr><td>C - 3</td><td>PLAN AND PROFILE</td><td>6 OF 11</td></tr><tr><td>C - 4</td><td>PLAN AND PROFILE</td><td>7 OF 11</td></tr><tr><td>C - 5</td><td>PLAN AND PROFILE</td><td>8 OF 11</td></tr><tr><td>C - 6</td><td>BORING LOGS</td><td>9 OF 11</td></tr><tr><td>D - 1</td><td>DETAILS</td><td>10 OF 11</td></tr><tr><td>D - 2</td><td>DETAILS</td><td>11 OF 11</td></tr></tbody></table> SUMITOMO CONSTRUCTION CO. LTD. AS-BUILT DRAWING This certifies that the dimensions and details shown on this sheet reflect the construction and details as constructed in the field. <i>[Signature]</i> <i>[Signature]</i> Signature Date	DRAWING NO.	DESCRIPTION	SHEET NO.	TS - 1	TITLE SHEET, LOCATION MAP, VICINITY MAP AND INDEX OF DRAWINGS	1 OF 11	LS - 1	GENERAL NOTES, ABBREVIATIONS & SYMBOLS	2 OF 11	MP - 1	KEY MAP	3 OF 11	C - 1	TREATMENT PLANT SITE AS-BUILT & EFFLUENT LINE LAYOUT PLAN	4 OF 11	C - 2	PLAN AND PROFILE	5 OF 11	C - 3	PLAN AND PROFILE	6 OF 11	C - 4	PLAN AND PROFILE	7 OF 11	C - 5	PLAN AND PROFILE	8 OF 11	C - 6	BORING LOGS	9 OF 11	D - 1	DETAILS	10 OF 11	D - 2	DETAILS	11 OF 11	<i>[Signature]</i> RICHARD A. QUINTANILLA GENERAL MANAGER GUAM WATERWORKS AUTHORITY <i>[Signature]</i> JESUS T. SALAS ADMINISTRATOR GUAM ENVIRONMENTAL PROTECTION AGENCY <i>[Signature]</i> ANTHONY T. QUINATA, P.E. DIRECTOR DEPARTMENT OF PUBLIC WORKS <table border="1"><thead><tr><th>REV.</th><th>DATE</th><th>BY</th><th>DESCRIPTION</th><th>APPROVED</th></tr></thead><tbody><tr><td>1</td><td></td><td></td><td></td><td></td></tr></tbody></table> PACIFIC ISLAND ENGINEERS CONSULTANTS P.O. BOX 4092, TAMUNING, GUAM 96931 TEL. NO. 845-7431/22 FAX NO. 845-1382 DES. P.E. DRN. CEC CHK. JAC/XYE SUPV. JAC DATE APRIL 87 SUBMITTED BY: <i>[Signature]</i> VINILLO NICOLAS PROJECT ENGINEER QUINTANO S. BARRAS, P.E. PROJECT CHIEF BENATO ALACAZAREN PROJECT MANAGER RECOMMENDED BY: <i>[Signature]</i> DATE JOB ORDER NO. QUINTANO S. BARRAS, P.E. ENGINEER BENATO ALACAZAREN ENGINEER TITLE SHEET, LOCATION MAP, VICINITY MAP & INDEX OF DRAWINGS SCALE: PWAG DWG. NO. SMT. 1 OF 11	REV.	DATE	BY	DESCRIPTION	APPROVED	1				
DRAWING NO.	DESCRIPTION	SHEET NO.																																															
TS - 1	TITLE SHEET, LOCATION MAP, VICINITY MAP AND INDEX OF DRAWINGS	1 OF 11																																															
LS - 1	GENERAL NOTES, ABBREVIATIONS & SYMBOLS	2 OF 11																																															
MP - 1	KEY MAP	3 OF 11																																															
C - 1	TREATMENT PLANT SITE AS-BUILT & EFFLUENT LINE LAYOUT PLAN	4 OF 11																																															
C - 2	PLAN AND PROFILE	5 OF 11																																															
C - 3	PLAN AND PROFILE	6 OF 11																																															
C - 4	PLAN AND PROFILE	7 OF 11																																															
C - 5	PLAN AND PROFILE	8 OF 11																																															
C - 6	BORING LOGS	9 OF 11																																															
D - 1	DETAILS	10 OF 11																																															
D - 2	DETAILS	11 OF 11																																															
REV.	DATE	BY	DESCRIPTION	APPROVED																																													
1																																																	