




SUMITOMO CONSTRUCTION CO. LTD
AS-BUILT DRAWING

This certifies that the dimensions and details shown on this sheet reflect the dimension and details as constructed in the field.

Signature: *[Signature]* Date: *4/1/99*

1
MP
KEY MAP

0 1/2 MILE 1 MILE

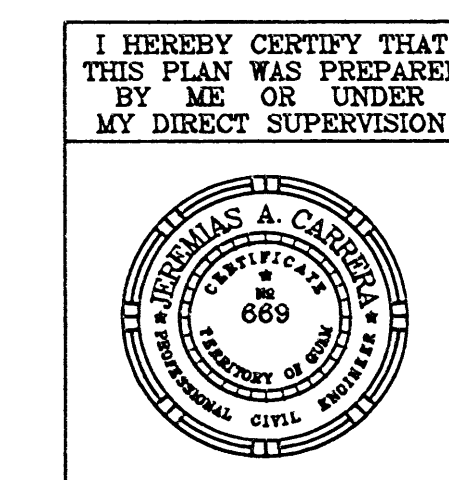

REV.	DATE	BY	DESCRIPTION	APPROVED	
	PACIFIC ISLAND ENGINEERS		GOVERNMENT OF GUAM GUAM WATERWORKS AUTHORITY		
	ENGINEERS • PLANNERS • C.M. CONSULTANTS				
	P.O. BOX 6020 TAMUNING, GUAM 96931 TEL. NO. 646-7453/2 FAX NO. 646-1982				
DES. PIE	DRN. CEC	CHK. JAC/FEY	NORTHERN DISTRICT SEWERAGE SYSTEM EFFLUENT FORCE MAIN REPLACEMENT		
SUPV. JAC	DATE	APRIL 97			
SUBMITTED BY:					
			KEY MAP		
			RECOMMENDED BY:		
VIRGILIO NICOLAS			DATE		JOB ORDER NO.
PROJECT ENGINEER			QUIRINO H. BASBAS, P.E.		DRAWING NO.
RENATO ALCAZAREN			CHIEF ENGINEER		MP - 1
PROJECT MANAGER			SCALE:	PUAG DWG. NO.	SHT. 3 OF 11